

RESOLUTION NO. 1000

A RESOLUTION OF THE CITY COUNCIL OF THE CITY OF GIG HARBOR, WASHINGTON, AMENDING THE WASTEWATER COMPREHENSIVE PLAN BY REVISING THE SEWER COLLECTION BASIN BOUNDARY BETWEEN SEWER COLLECTION BASINS #10 AND #11.

WHEREAS, in 2008 as part of the City's 56th Street/Olympic Drive Improvement Project the City installed over \$200,000 worth of dry sewer mains within sewer basin #10 intended to serve plats along 38th Avenue; and

WHEREAS, this dry sewer main was installed very deep to maximize gravity sewer flows within sewer basin #10; and

WHEREAS, this deep sewer main was not anticipated when the City's 2009 Wastewater Comprehensive Plan (WWCP) was under development in 2007, therefore sewer basin boundaries in sewer basin #10 were established based on standard sewer main depths; and

WHEREAS, the City's Public Works Department recognizes the deep sewer main creates the opportunity to collect sewer by means of gravity in a larger area; and

WHEREAS, sewer basin #11 is not likely to develop sewer collection infrastructure any time in the near future due to the expense of constructing sewer mains and a sewer lift station and a lack of developable land within sewer basin #11; and

WHEREAS, the Public Works Department requests the boundary between sewer basins #10 and #11 be amended to transfer approximately 17 acres from sewer basin #11 to sewer basin #10 because sewer basin #10 is more likely to be developed in the near future due to lower sewer development expenses and more developable land; and

WHEREAS, both sewer basin #10 and sewer basin #11 will discharge to sewer basin #8, therefore sewer flow rates to downstream sewer infrastructure would not be altered by the proposed technical amendment; and

WHEREAS, Section 1.4.2 of the WWCP requires technical amendments to be adopted by resolution by the City Council; and

WHEREAS, the Public Works Director believes the information provided sufficiently justifies a technical amendment to the WWCP.


WHEREAS, on June 15, 2015, the Public Works Committee heard the City's requested comprehensive plan amendment and recommended the request move forward to the City Council; and

WHEREAS, on June 22, 2015, the Gig Harbor City Council held a public hearing on WH Gig Harbor LLCs requested comprehensive plan amendment

NOW, THEREFORE, BE IT RESOLVED by the City Council of the City of Gig Harbor, Washington:


Section 1. Appendix B of the WWCP shall be amended to reflect the revisions to the Wastewater Basin Map as provided in the attached Exhibit "A".

PASSED this 13th day of July, 2015.

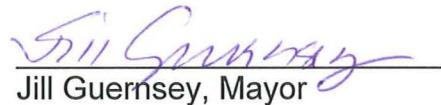




Jill Guernsey, Mayor

ATTEST:

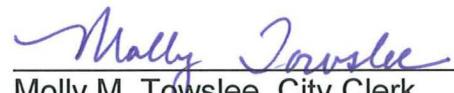

Molly M. Towslee, City Clerk

FILED WITH THE CITY CLERK: 06/18/15
PASSED BY THE CITY COUNCIL: 06/22/15
RESOLUTION NO. 1000

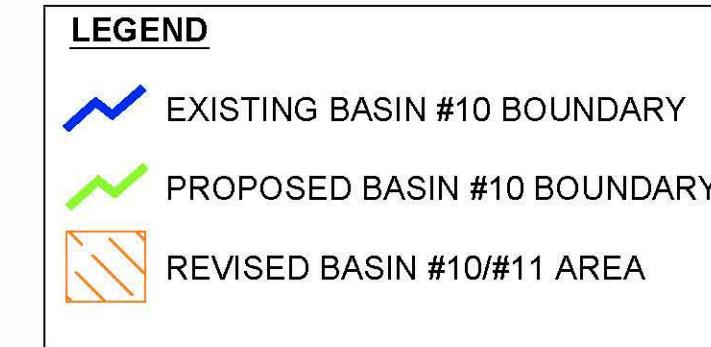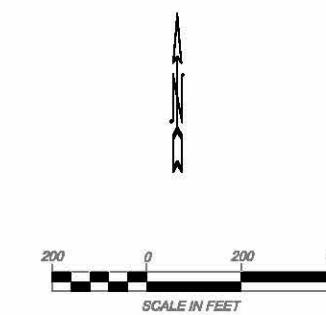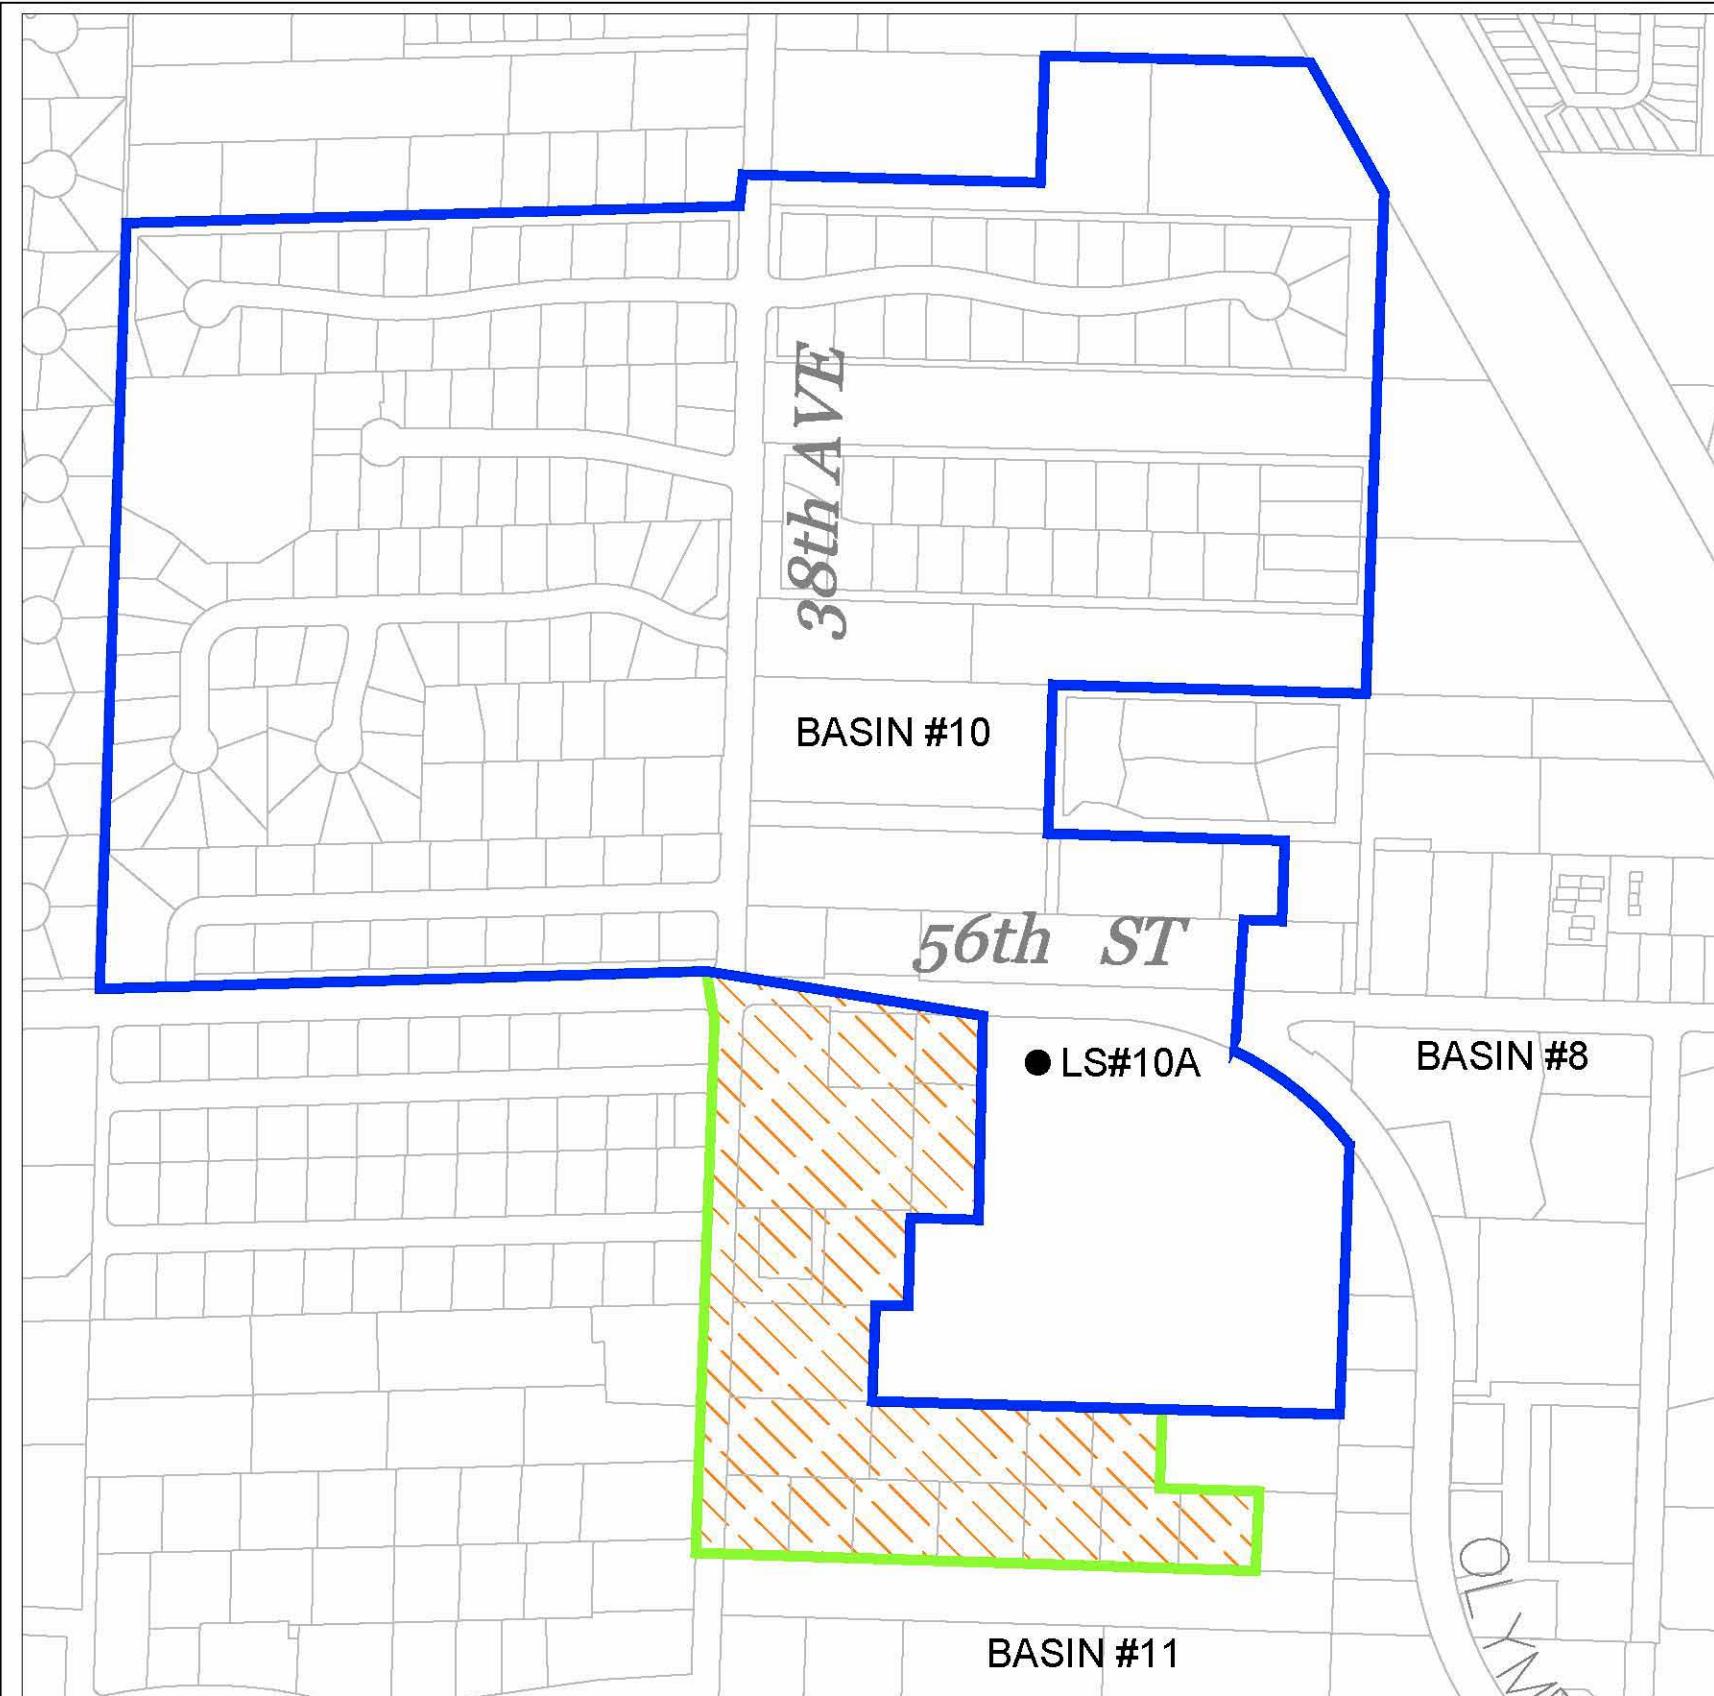

REVISIONS	 <p>PUBLIC WORKS DEPARTMENT</p> <p>3510 Grandview Street Gig Harbor, WA 98335 (253) 851-6170 www.cityofgigharbor.net</p>	DESIGNED BY: DRAWN BY: CHECKED BY: APPROVED BY: SCALE: OTHER:	<p>WASTEWATER COMP PLAN AMENDMENT - BASIN No. 10 AND 11</p>	JOB NO. -	DRAWING NO. X